



BRICKELL


12TH FLOOR - SUITE 1250 (12,253 RSF)




DOWNTOWN
MIAMI

BRICKELL AVE

AS BUILT

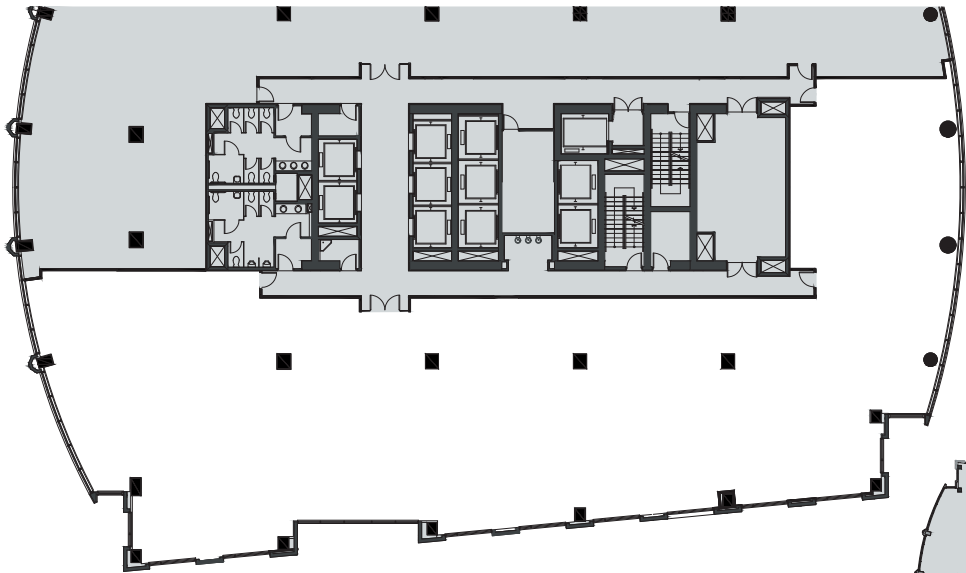

KEY PLAN

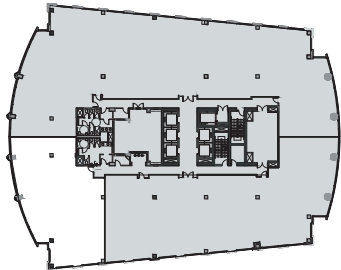

BRICKELL BAY DR



B L A N C A

All areas, dimensions and conditions are approximate and subject to change. Actual areas, dimensions and conditions should be verified.

